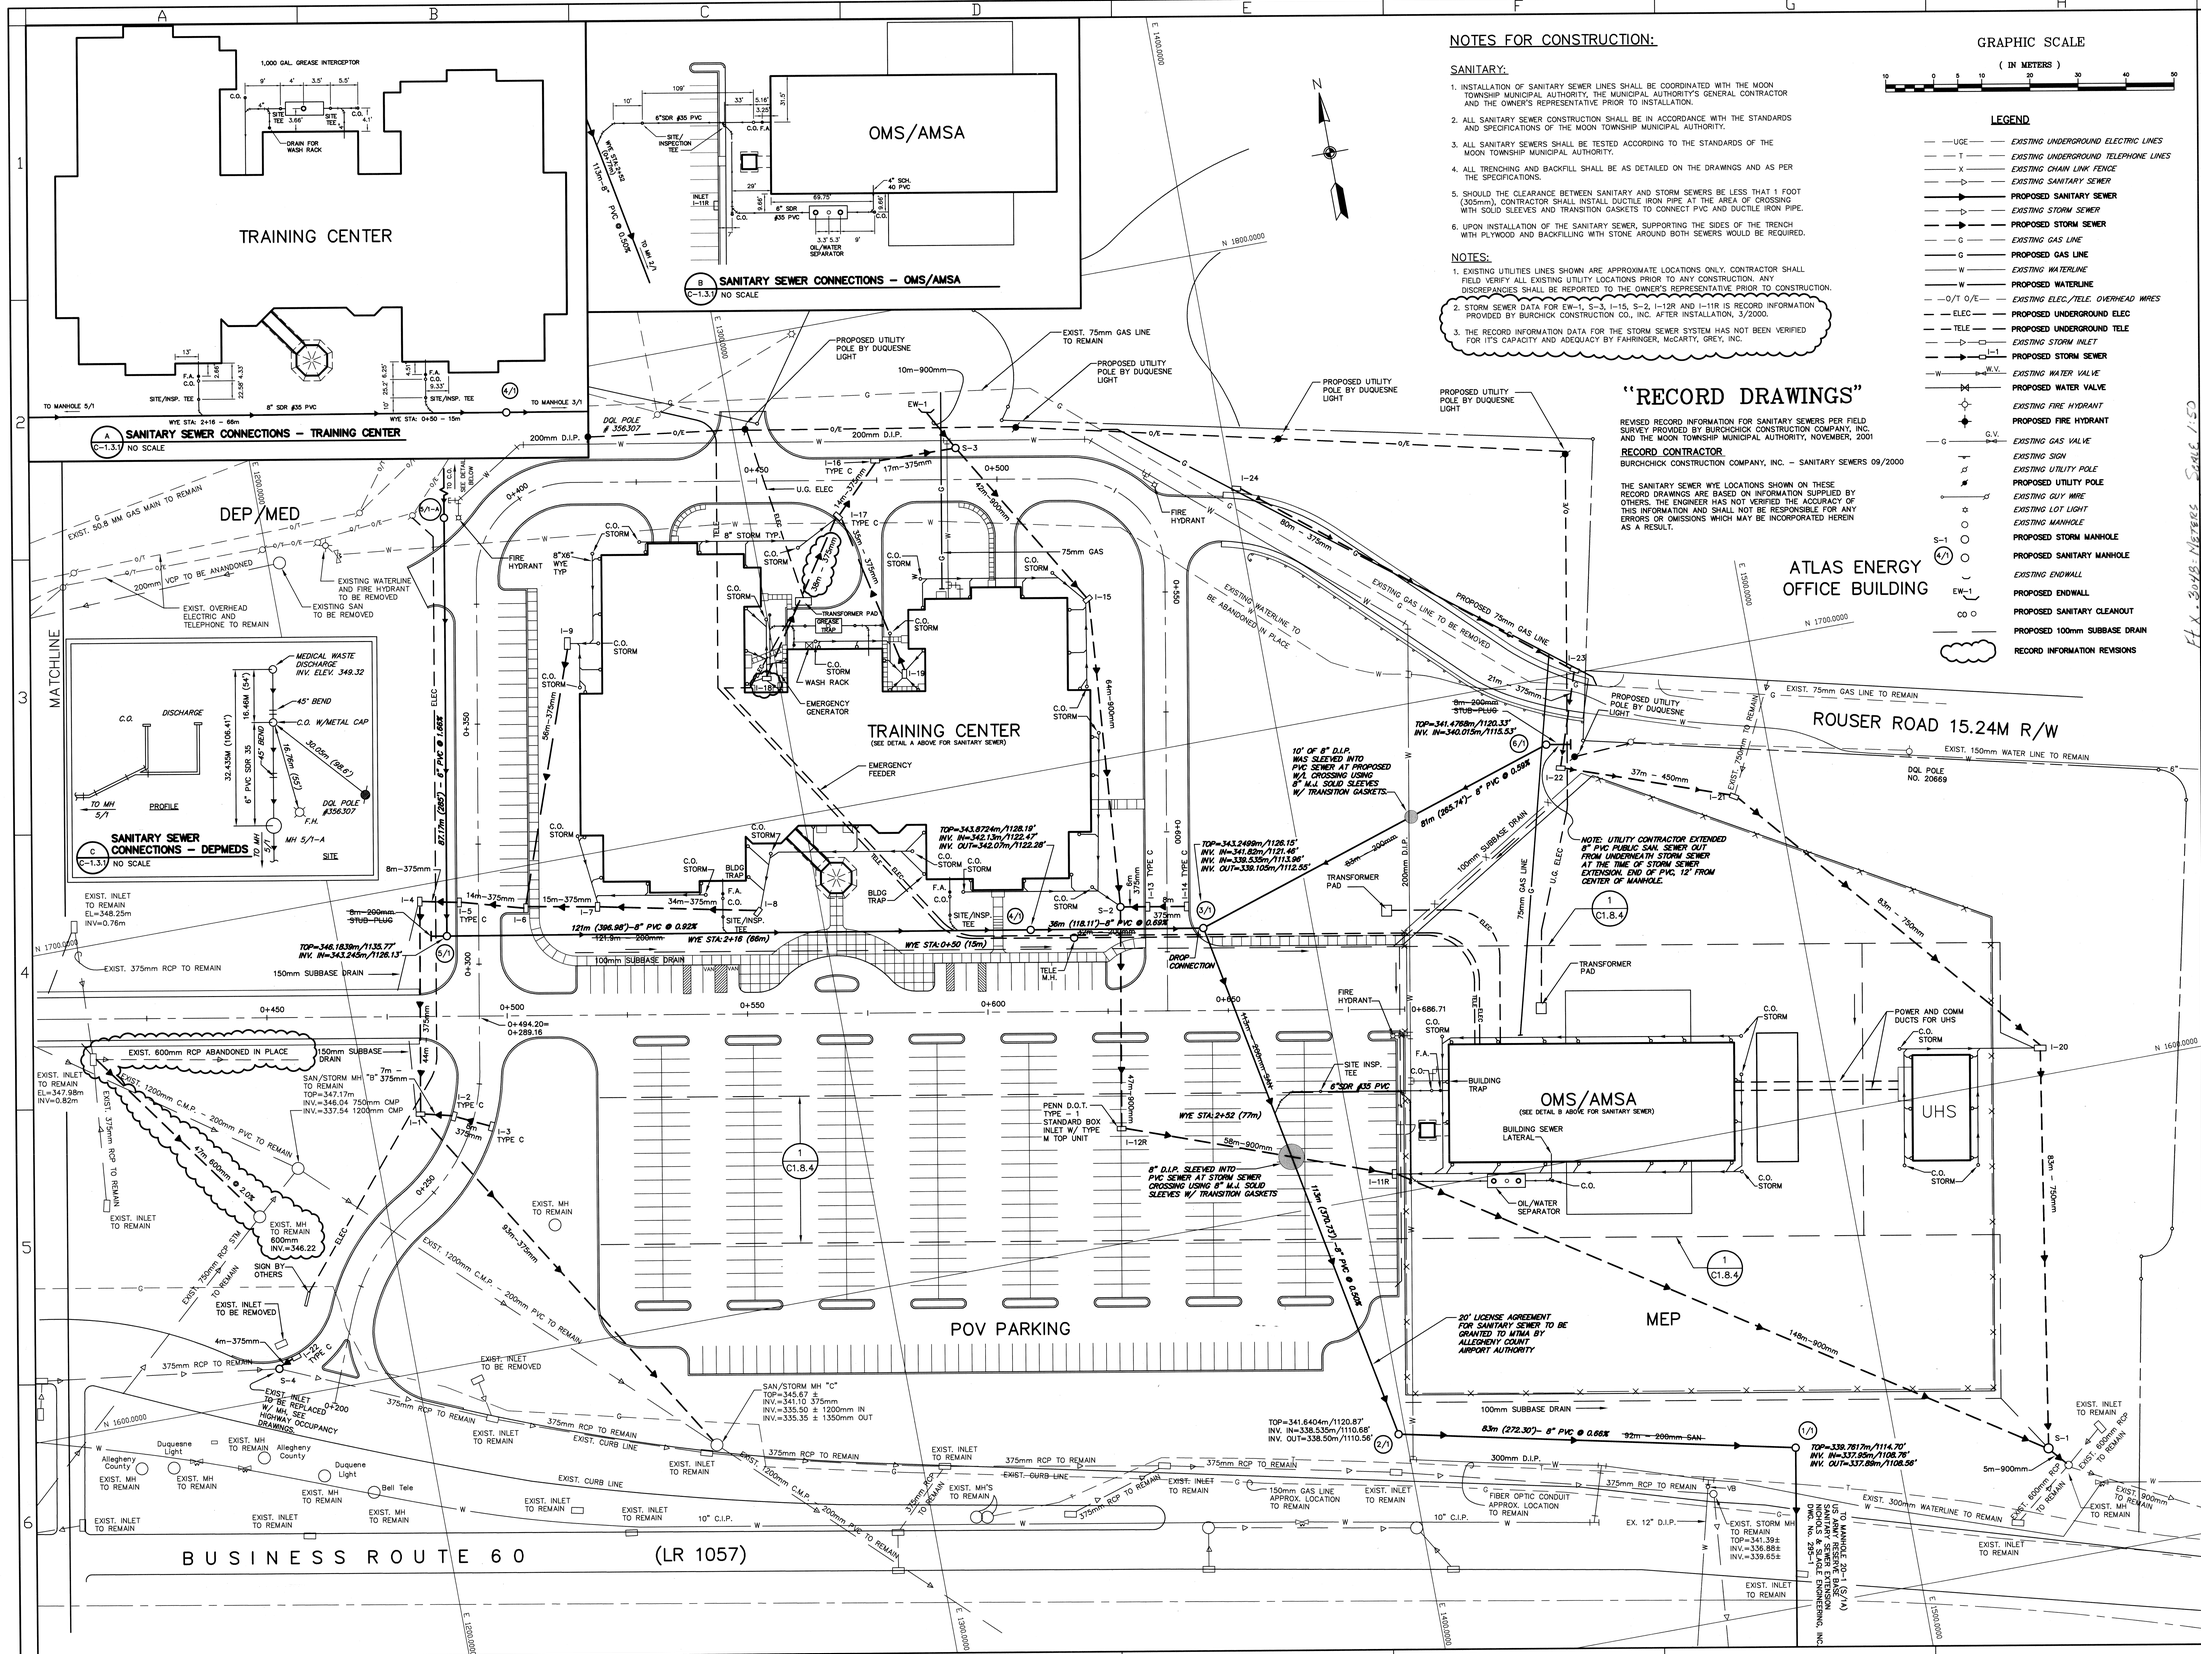

NOTES FOR CONSTRUCTION:

SANITARY:

1. INSTALLATION OF SANITARY SEWER LINES SHALL BE COORDINATED WITH THE MOON TOWNSHIP MUNICIPAL AUTHORITY, THE MUNICIPAL AUTHORITY'S GENERAL CONTRACTOR AND THE OWNER'S REPRESENTATIVE PRIOR TO INSTALLATION.
2. ALL SANITARY SEWER CONSTRUCTION SHALL BE IN ACCORDANCE WITH THE STANDARDS AND SPECIFICATIONS OF THE MOON TOWNSHIP MUNICIPAL AUTHORITY.
3. ALL SANITARY SEWERS SHALL BE TESTED ACCORDING TO THE STANDARDS OF THE MOON TOWNSHIP MUNICIPAL AUTHORITY.
4. ALL TRENCHING AND BACKFILL SHALL BE AS DETAILED ON THE DRAWINGS AND AS PER THE SPECIFICATIONS.
5. SHOULD THE CLEARANCE BETWEEN SANITARY AND STORM SEWERS BE LESS THAT 1 FOOT (305mm), CONTRACTOR SHALL INSTALL DUCTILE IRON PIPE AT THE AREA OF CROSSING WITH SOLID SLEEVES AND TRANSITION GASKETS TO CONNECT PVC AND DUCTILE IRON PIPE.
6. UPON INSTALLATION OF THE SANITARY SEWER, SUPPORTING THE SIDES OF THE TRENCH WITH PLYWOOD AND BACKFILLING WITH STONE AROUND BOTH SEWERS WOULD BE REQUIRED.

NOTES:

1. EXISTING UTILITIES LINES SHOWN ARE APPROXIMATE LOCATIONS ONLY. CONTRACTOR SHALL FIELD VERIFY ALL EXISTING UTILITY LOCATIONS PRIOR TO ANY CONSTRUCTION; ANY DISCREPANCIES SHALL BE REPORTED TO THE OWNER'S REPRESENTATIVE PRIOR TO CONSTRUCTION.
2. STORM SEWER DATA FOR EW-1, S-3, I-15, S-2, I-12R AND I-11R IS RECORD INFORMATION PROVIDED BY BURCHICK CONSTRUCTION CO., INC. AFTER INSTALLATION, 3/2000.
3. THE RECORD INFORMATION DATA FOR THE STORM SEWER SYSTEM HAS NOT BEEN VERIFIED FOR IT'S CAPACITY AND ADEQUACY BY FAHRINGER, McCARTY, GREY, INC.

"RECORD DRAWINGS"

REVISED RECORD INFORMATION FOR SANITARY SEWERS PER FIELD SURVEY PROVIDED BY BURCHCHICK CONSTRUCTION COMPANY, INC. AND THE MOON TOWNSHIP MUNICIPAL AUTHORITY, NOVEMBER, 2001

RECORD CONTRACTOR

BURCHCHICK CONSTRUCTION COMPANY, INC. - SANITARY SEWERS 09/2000

THE SANITARY SEWER WYE LOCATIONS SHOWN ON THESE RECORD DRAWINGS ARE BASED ON INFORMATION SUPPLIED BY OTHERS. THE ENGINEER HAS NOT VERIFIED THE ACCURACY OF THIS INFORMATION AND SHALL NOT BE RESPONSIBLE FOR ANY ERRORS OR OMISSIONS WHICH MAY BE INCORPORATED HEREIN AS A RESULT.

US ARMY CORPS OF ENGINEERS
LOUISVILLE DISTRICT

Symbol	Description	Date	Appr.
	PER REVIEW BY NICHOLS & SLAGLE ENGINEERING, INC.	04/07/00	
	PER REVIEW BY NICHOLS & SLAGLE ENGINEERING, INC.	04/10/00	
	PER REVIEW BY MOON TOWNSHIP MUNICIPAL AUTHORITY	05/12/00	
	PER REVIEW BY MOON TOWNSHIP MUNICIPAL AUTHORITY	11/09/01	

Revisions

FAHRINGER, McCARTY, GREY, INC.
LANDSCAPE ARCHITECTS AND ENGINEERS MONROEVILLE, PA.

Designed by: K. WURSTEL
Dwn by: J. EVANS
Ckd by: R. CRAFT
Reviewed by: D. EARL
Submitted by:
Date: MAY 12, 2000
Rev.
Drawing Number:
Drawing Code:
Specification Code:

UTILITY PLAN

PROJECT:
USARC/OMS/AMSA #105
OAKDALE (PITTSBURGH), PA
PN-I0982 AND PN-I0983 FY99

C1.3.1

SHEET 2 OF 2

SEALED DRAWINGS

A-312

5-0098